
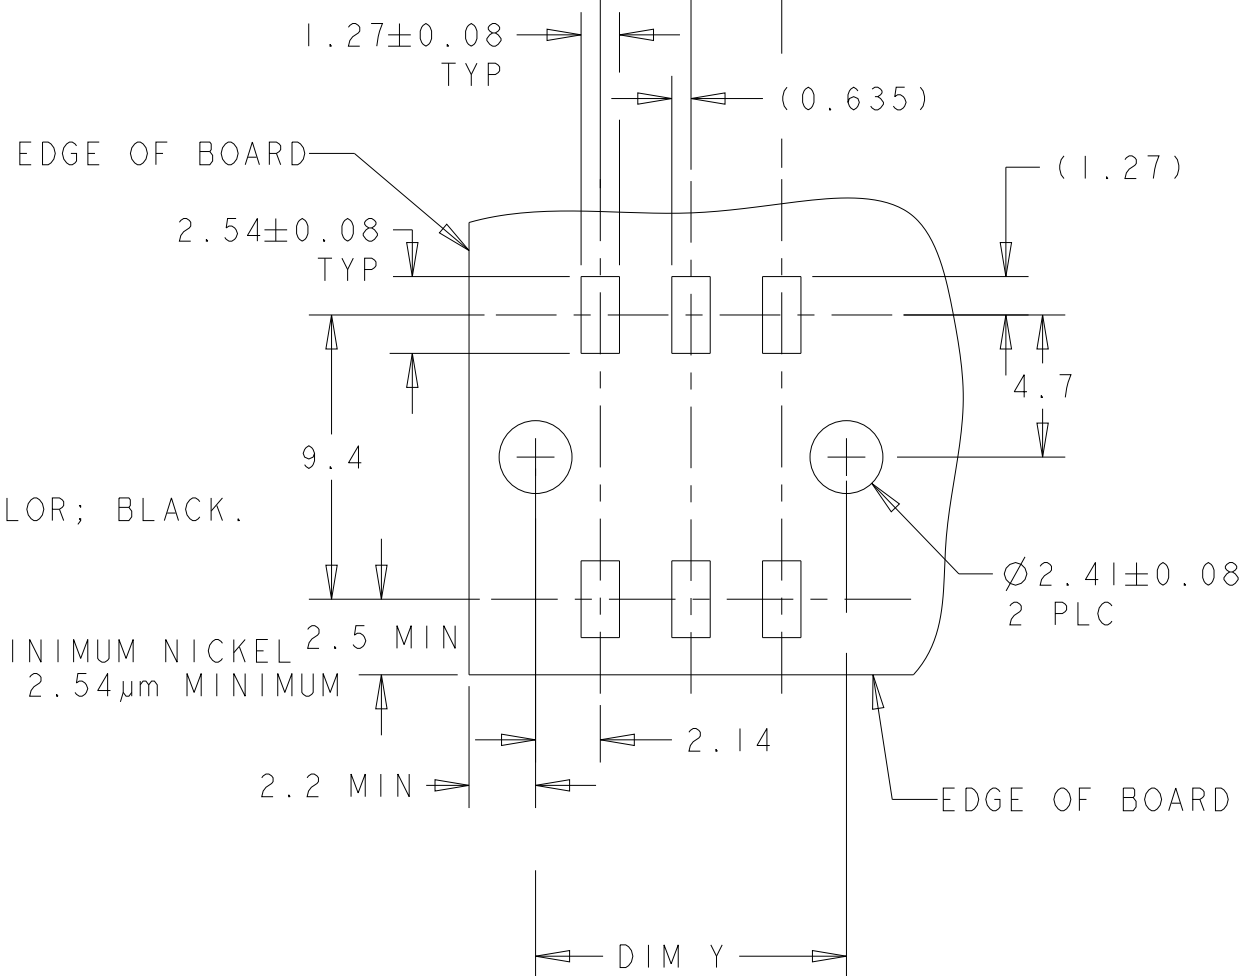
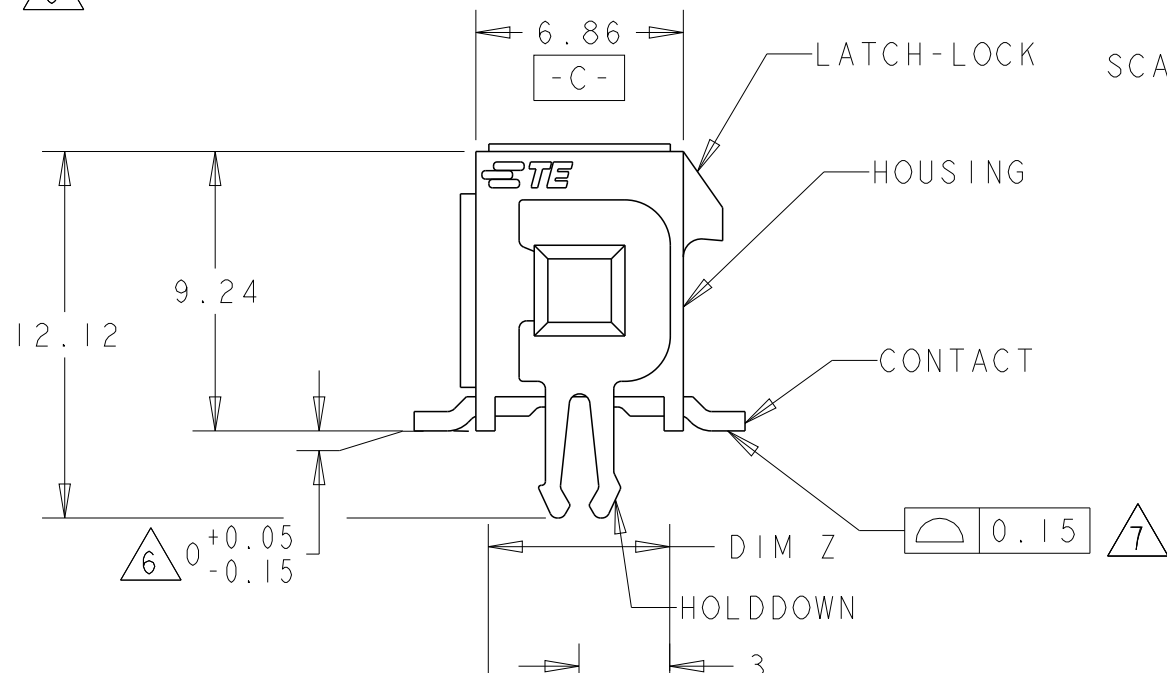
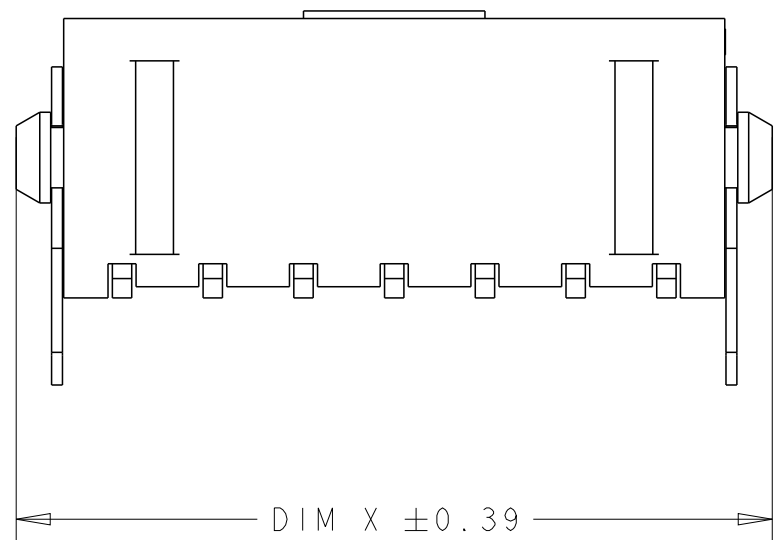


| REVISIONS |     |                           |           |     |      |
|-----------|-----|---------------------------|-----------|-----|------|
| P         | LTR | DESCRIPTION               | DATE      | DWN | APVD |
|           | J2  | REVISED PER ECR-17-017609 | 04DEC2017 | JB  | DZ   |
|           |     |                           |           |     |      |
|           |     |                           |           |     |      |
|           |     |                           |           |     |      |

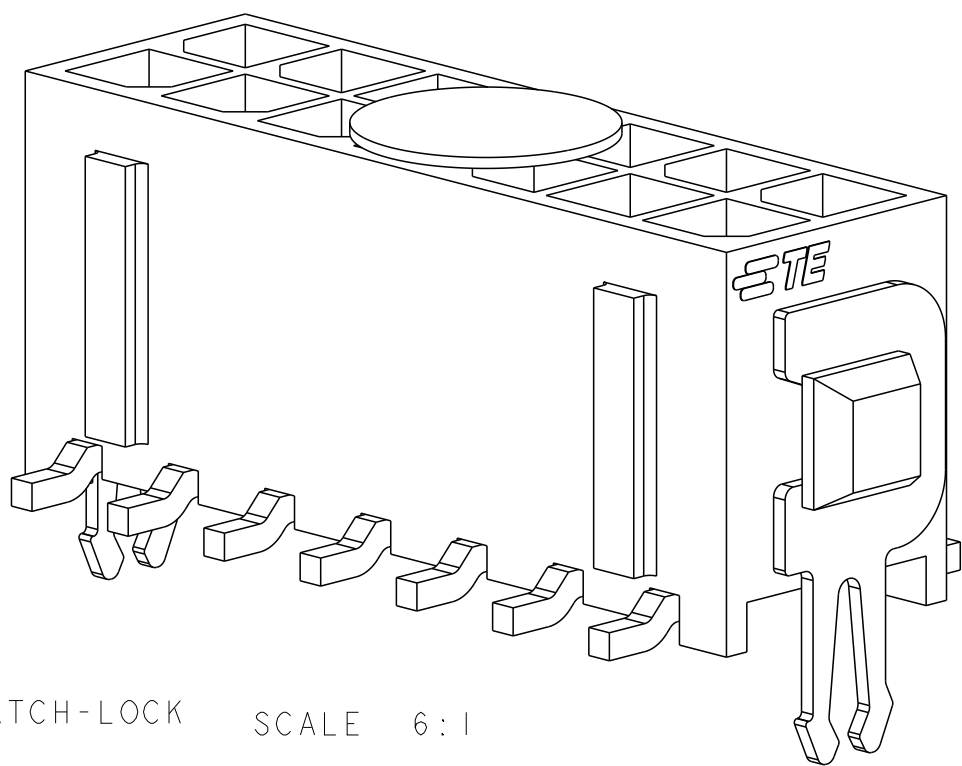

- 9 CIRCUIT NUMBER 1 IS LOCATED AT THE BOTTOM RIGHT  
WITH THE LATCH-LOCK ON TOP LOOKING INTO THE CAVITIES

SCALE 6 : 1

|                                                                                       |       |       |       |       |              |                       |
|---------------------------------------------------------------------------------------|-------|-------|-------|-------|--------------|-----------------------|
|    | 36.86 | 37.30 | 33.00 | 40.00 | 24           | 5-794634-4            |
|    | 33.86 | 34.30 | 30.00 | 37.00 | 22           | 5-794634-2            |
|    | 30.86 | 31.30 | 27.00 | 34.00 | 20           | 5-794634-0            |
|    | 27.86 | 28.30 | 24.00 | 31.00 | 18           | 4-794634-8            |
|    | 24.86 | 25.30 | 21.00 | 28.00 | 16           | 4-794634-6            |
|    | 21.86 | 22.30 | 18.00 | 25.00 | 14           | 4-794634-4            |
|   | 18.86 | 19.30 | 15.00 | 22.00 | 12           | 4-794634-2            |
|  | 15.86 | 16.30 | 12.00 | 19.00 | 10           | 4-794634-0            |
|  | 12.86 | 13.30 | 9.00  | 16.00 | 8            | 3-794634-8            |
|  | 9.86  | 10.30 | 6.00  | 13.00 | 6            | 3-794634-6            |
|  | 6.86  | 7.30  | 3.00  | 10.00 | 4            | 3-794634-4            |
|  | 3.86  | 4.30  | -     | 7.00  | 2            | 3-794634-2            |
|  | 36.86 | 37.30 | 33.00 | 40.00 | 24           | <del>2-794634-4</del> |
|  | 33.86 | 34.30 | 30.00 | 37.00 | 22           | <del>2-794634-2</del> |
|  | 30.86 | 31.30 | 27.00 | 34.00 | 20           | <del>2-794634-0</del> |
|  | 27.86 | 28.30 | 24.00 | 31.00 | 18           | <del>1-794634-8</del> |
|  | 24.86 | 25.30 | 21.00 | 28.00 | 16           | <del>1-794634-6</del> |
|  | 21.86 | 22.30 | 18.00 | 25.00 | 14           | <del>1-794634-4</del> |
|  | 18.86 | 19.30 | 15.00 | 22.00 | 12           | <del>1-794634-2</del> |
|  | 15.86 | 16.30 | 12.00 | 19.00 | 10           | <del>1-794634-0</del> |
|  | 12.86 | 13.30 | 9.00  | 16.00 | 8            | <del>794634-8</del>   |
|  | 9.86  | 10.30 | 6.00  | 13.00 | 6            | <del>794634-6</del>   |
|  | 6.86  | 7.30  | 3.00  | 10.00 | 4            | <del>794634-4</del>   |
|  | 3.86  | 4.30  | -     | 7.00  | 2            | <del>794634-2</del>   |
| FINISH                                                                                | DIM V | DIM Y | DIM Z | DIM X | NO. OF POSN. | PART NUMBER           |

|                                                                                                   |  |                                                                                                                                  |  |                                                                                                                   |                    |                        |                    |
|---------------------------------------------------------------------------------------------------|--|----------------------------------------------------------------------------------------------------------------------------------|--|-------------------------------------------------------------------------------------------------------------------|--------------------|------------------------|--------------------|
| THIS DRAWING IS A CONTROLLED DOCUMENT.                                                            |  | DWN<br>K. WHITAKER<br>19MAR2003<br>CHK<br>C. JONES<br>19MAR2003<br>APVD<br>C. JONES<br>19MAR2003                                 |  |  TE Connectivity             |                    |                        |                    |
| DIMENSIONS:<br>mm                                                                                 |  | TOLERANCES UNLESS OTHERWISE SPECIFIED:<br><br>0 PLC ±-<br>1 PLC ±-<br>2 PLC ±0.13<br>3 PLC ±-<br>4 PLC ±-<br>ANGLES ±-<br>FINISH |  | NAME<br>SURFACE MOUNT, VERTICAL, MECHANICAL<br>HOLDDOWN, ASSEMBLY, 15 GOLD HEADER,<br>DUAL ROW, MICRO MATE-N-LOK™ |                    |                        |                    |
|              |  | PRODUCT SPEC<br>-<br>APPLICATION SPEC<br>-<br>WEIGHT<br>-                                                                        |  |                                                                                                                   |                    |                        |                    |
| MATERIAL<br> |  | SEE TABLE                                                                                                                        |  | SIZE<br>A2                                                                                                        | CAGE CODE<br>60779 | DRAWING NO<br>C-794634 | RESTRICTED TO<br>- |
| CUSTOMER DRAWING                                                                                  |  |                                                                                                                                  |  | SCALE<br>4:1                                                                                                      | SHEET<br>1         | OF<br>1                | REV<br>J2          |